

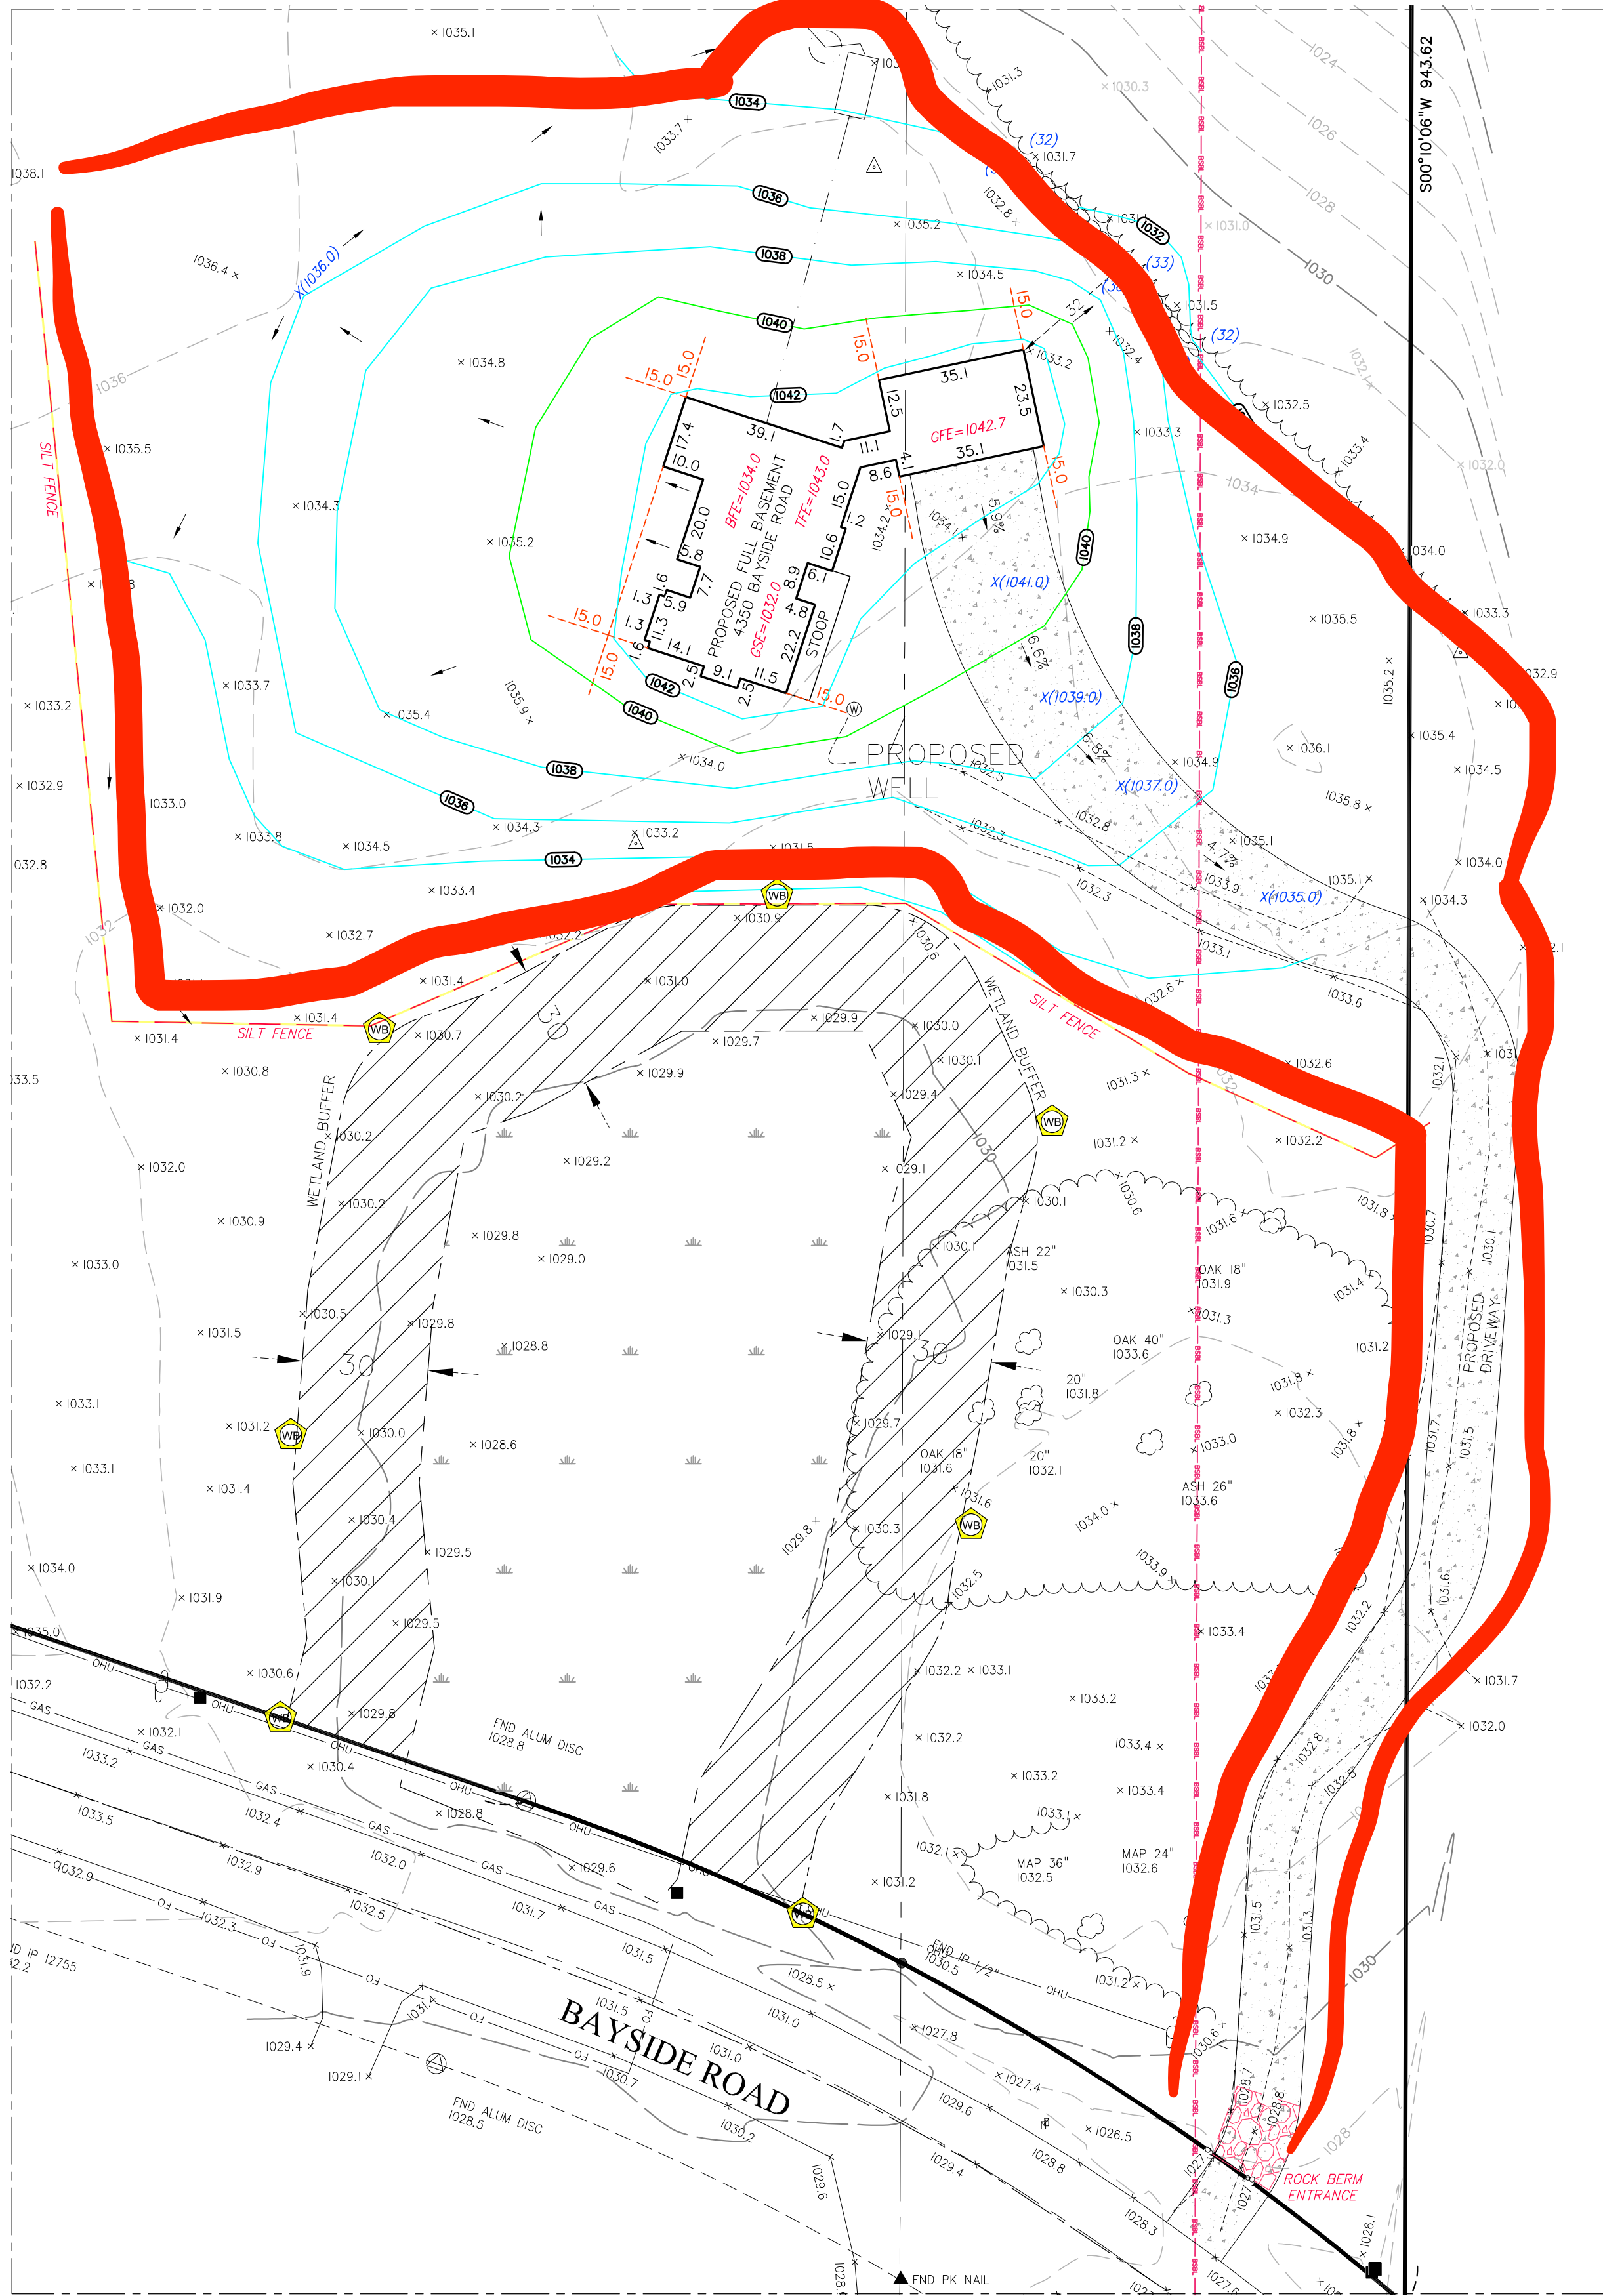


DETAIL A

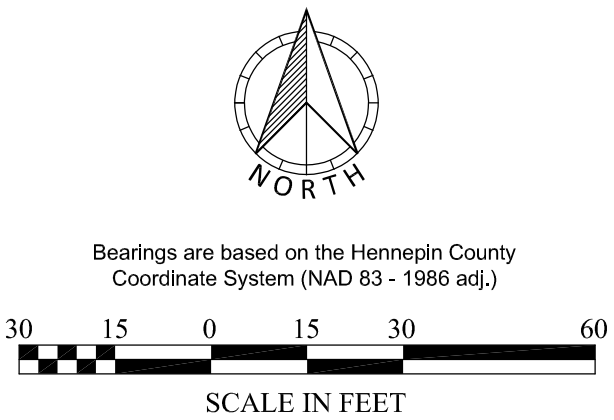

Red lines = silt fence

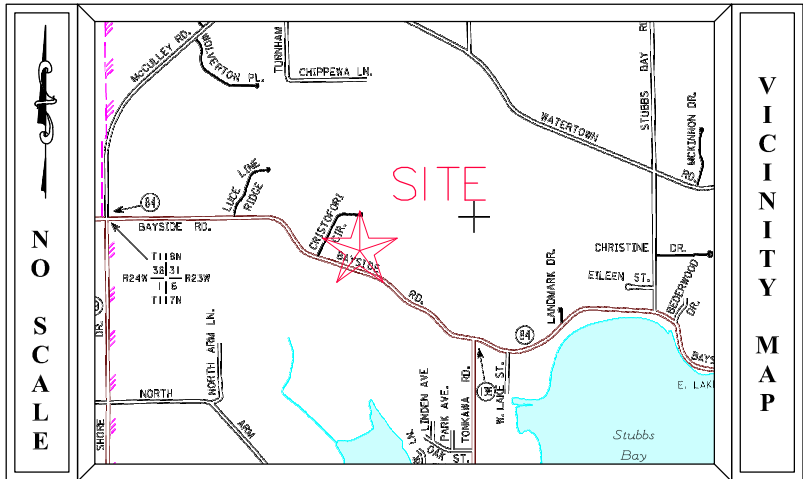

SURVEY LEGEND

- | | | |
|-------------------------------|---------------------------|-----------------------------|
| ● CAST IRON MONUMENT | ⊙ PIEZOMETER | WOC WALKOUT ELEVATION |
| ○ IRON PIPE MONUMENT SET | ⊙ POWER POLE | FFE FIRST FLOOR ELEVATION |
| ● IRON PIPE MONUMENT FOUND | ⊙ GUY WIRE | GFE GARAGE FLOOR ELEVATION |
| × DRILL HOLE FOUND | ⊙ ROOF DRAIN | TOF TOP OF FOUNDATION ELEV. |
| × CHISELED "X" MONUMENT SET | ⊙ LIFT STATION | LOE LOWEST OPENING ELEV. |
| × CHISELED "X" MONUMENT FOUND | ⊙ SANITARY MANHOLE | CONCRETE |
| ⊙ REBAR MONUMENT FOUND | ⊙ SANITARY CLEANOUT | BITUMINOUS |
| ⊙ PK NAIL MONUMENT SET | ⊙ STORM MANHOLE | BUILDING SETBACK LINE |
| ⊙ PK NAIL MONUMENT FOUND | ⊙ STORM DRAIN | CABLE TV |
| ⊙ PK NAIL W/ ALUMINUM DISC | ⊙ CATCH BASIN | CONCRETE CURB |
| ⊙ SURVEY CONTROL POINT | ⊙ FLARED END SECTION | CONTOUR EXISTING |
| ⊙ A/C UNIT | ⊙ TREE CONIFEROUS | CONTOUR PROPOSED |
| ⊙ CABLE TV PEDESTAL | ⊙ TREE DECIDUOUS | GUARD RAIL |
| ⊙ ELECTRIC TRANSFORMER | ⊙ TREE CONIFEROUS REMOVED | DRAIN TILE |
| ⊙ ELECTRIC MANHOLE | ⊙ TREE DECIDUOUS REMOVED | ELC ELECTRIC UNDERGROUND |
| ⊙ ELECTRIC METER | ⊙ TELEPHONE MANHOLE | FENCE |
| ⊙ ELECTRIC OUTLET | ⊙ UTILITY MANHOLE | FO FIBER OPTIC UNDERGROUND |
| ⊙ YARD LIGHT | ⊙ UTILITY PEDESTAL | GAS UNDERGROUND |
| ⊙ LIGHT POLE | ⊙ UTILITY VAULT | OVERHEAD UTILITY |
| ⊙ FIBER OPTIC MANHOLE | ⊙ WATERMAIN MANHOLE | OHU |
| ⊙ FIRE DEPT. HOOK UP | ⊙ WATER METER | SANITARY SEWER |
| ⊙ FLAG POLE | ⊙ WATER SPIGOT | STORM SEWER |
| ⊙ FUEL TANK | ⊙ MONITORING WELL | TEL TELEPHONE UNDERGROUND |
| ⊙ PROPANE TANK | ⊙ CURB STOP | RETAINING WALL |
| ⊙ GAS METER | ⊙ GATE VALVE | UTL UTILITY UNDERGROUND |
| ⊙ GAS VALVE | ⊙ HYDRANT | WATERMAIN |
| ⊙ GAS MANHOLE | ⊙ IRRIGATION VALVE | TRAFFIC SIGNAL |
| ⊙ GENERATOR | ⊙ POST INDICATOR VALVE | RAILROAD TRACKS |
| ⊙ GUARD POST | ⊙ SIGN | RAILROAD SIGNAL |
| ⊙ HAND HOLE | ⊙ SOIL BORING | RAILROAD SWITCH |
| ⊙ MAIL BOX | | SATELLITE DISH |
| | | WETLAND BUFFER SIGN |

FIELD CREW	NO.	BY	DATE	REVISION
DM/DO/DO				
DRAWN				
GMK				
CHECKED				
DLS				
DATE				
08/14/2025				


USE (INCLUDING COPYING, DISTRIBUTION, AND/OR CONVEYANCE OF INFORMATION) OF THIS PRODUCT IS STRICTLY PROHIBITED WITHOUT SATHRE-BERGQUIST, INC.'S EXPRESS WRITTEN AUTHORIZATION. USE WITHOUT SAID AUTHORIZATION CONSTITUTES AN ILLEGITIMATE USE AND SHALL THEREBY INDEMNIFY SATHRE-BERGQUIST, INC. OF ALL RESPONSIBILITY. SATHRE-BERGQUIST, INC. RESERVES THE RIGHT TO HOLD ANY ILLEGITIMATE USER OR PARTY LEGALLY RESPONSIBLE FOR DAMAGES OR LOSSES RESULTING FROM ILLEGITIMATE USE.

I hereby certify that this survey, plan or report was prepared by me or under my direct supervision and that I am a duly Licensed Land Surveyor under the laws of the State of Minnesota.

Dated this 16th day of October, 2025.

Daniel L. Schmidt

Daniel L. Schmidt, PLS
schmidt@sathre.com
Minnesota License No. 26147

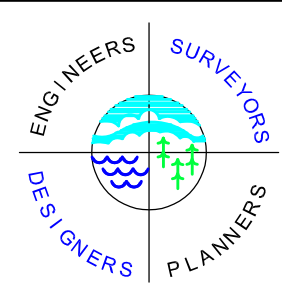

SATHRE-BERGQUIST, INC.

14000 25TH AVENUE NORTH, SUITE 120
PLYMOUTH MN 55447 (952) 476-6000
WWW.SATHRE.COM

TWP:117-RGE,23-SEC.06

**ORONO,
MINNESOTA**

Certificate of Survey

PREPARED FOR:

HARMON HAUS

FILE NO.

32985-001

2

2